Addendum No. 2

1/30/25

## College of Southern Idaho Leroy Craig Center

This addendum addresses the following:

- Substitution Approvals
- Interior Paint
- Toilet Compartments
- Metal Lockers
- Food Service Equipment
- Sheets A3.1a , S1,02 & S1.03 and Enlarged floor plan sheet A3.4
- Room Finish Schule Sheet A4.1
- Sheet FS-101 Food Service Equipment Plan
- Civil addendum #2
- Mechanical Addendum #2
- Electrical Addendum #2
- Sketches and Land design addendum #2
- Remove Concrete Floor Epoxy Coating from Painting bid package BP-18, as stated in the specifications 099133-8, this has its own bid package BP-17, Specification section 096723, Resinous Flooring.

Bid date is at 2:00PM, Thursday, February 27, 2025.

Attachments

• LKV Addendum No. 2

End of Add. No. 2





## ADDENDUM NO. 2 January 30, 2025

## PROJECT: LeRoy Craig Jerome Center College of Southern Idaho Jerome, Idaho

The following Addendum applies to the Drawings and/or Specifications for this project and shall be part of the Contract Documents.

## **SPECIFICATIONS**

## SPECIFICATION 099123 INTERIOR PAINT

1. 3.6 INTERIOR PAINTING SCHEDULE, paragraph G: Delete paragraph G in its entirety. Refer to SPECIFICATION 096723 RESINOUS FLOORING, and as revised by Addendum No. 1 for the High-Performance Resinous Floor and Cove system.

## SPECIFICATION 102113 TOILET COMPARTMENTS

1. Paragraph 2.2, E: Delete all references to and requirements for SCRC materials. Provide HPDE panels as specified.

## SPECIFICATION 105113 METAL LOCKERS

1. Paragraphs 2.1 E, & 2.2 C: Delete all references to and requirements for Knocked-Down construction. Provide all welded metal lockers in accordance with specified manufacturer's requirements.

## SPECIFICATION 114000 FOOD SERVICE EQUIPMENT

- 2. Paragraph 3.9 Food Service Equipment: The following are clarifications to the Equipment Schedule:
  - a. ITEM 17: SCALE / LABELER, add (BY OWNER).
  - b. ITEM 18: FOOD SLICER, add (BY OWNER).
  - c. ITEM 19: SLICER CART, add (BY OWNER).
  - d. ITEM 47: MOBILE WORK, add (BY OWNER).

## **DRAWINGS**

## SHEETS A3.1a DIMENSION FLOOR PLAN, S1.02 ROOF FRAMING PLAN, & S1.03 HIGH ROOF FRAMING PLAN.

1. See attached Sketch SK-2 for clarifications to the meat rail layout dimensions in TRAINING LAB 2 and accordingly, attached Sketches LESK 01 and LESK 02 for adjustments to supporting structural steel. (re: Sheets S1.02 & S1.03)

## SHEET A3.4 ENLARGED FLOOR PLANS

1. Detail 3 Epoxy Floor Cove Base: Delete the Keyed Note 066400.A1 pointing to the floor under the stud wall base track and provide 054000.J Sill Sealer continuous under track.

## SHEET A4.1 ROOM FINISH SCHEDULE

1. At Rooms 123 MEN, 124 WOMEN, 126 NURSING MOMS, & 127 TOILET: Change Remark #2 to read CERAMIC WALL TILE WAINSCOT TO 7'-6" A.F.F.

## SHEET FS-101 FOODSERVICE EQUIPMENT PLAN

- 1. Food Service Equipment Schedule: The following are clarifications to the Equipment Schedule:
  - a. ITEM 15: WORK TABLE, delete BY OWNER.
  - b. ITEM 45: LOCKERS, delete BY OWNER.

## <u>CIVIL</u>

1. See Civil Addendum #2 from Breckon Land Design dated 1-29 2025 with indicated revised drawings. (attached herein to Addendum No. 2)

## **MECHANICAL**

1. See Mechanical Addendum #2 from Musgrove Engineering dated 1/30/25. (attached herein to Addendum No. 2)

## ELECTRICAL

 See Electrical Addendum #2 from Musgrove Engineering dated 1/30/25. (attached herein to Addendum No. 2)

## **APPROVALS**

The following approvals are for manufacturers of products only unless specified products or systems are indicated. Contractor is responsible for providing product and/or materials that are equivalent in size, performance, quality, and appearance to those specified. Contractor is responsible for all conditions and/or field adaptations required for approved products other than those specified.


This acceptance is an acceptance of quality only. No attempt has been made to check each material as to special features, capacities or physical dimensions especially required by this project. Final acceptance of exact features, sizes, capacities, etc. all of which must match materials indicated specified, will be determined when submitted during construction period. Certain acceptances are subject to conditions as noted.


SPECIFICATION SECTION NO.	ITEM	MANUFACTURER / PRODUCT
096723 Resinous Flooring	Resinous Flooring	Key Resin / FlowFresh SL
083513 Folding Alum. Entrance	Folding Alum. Entrance	Sunflex / SF 55
084115 Aluminum Storefronts	Sunshades	Arcadia / Brise Soleil Standard
084513 Translucent Curtainwall	Translucent Curtainwall	Danpal / Danapatherm K12 (and K7)
102226 Operable Partitions	Operable Partition	Kwik-Wall / 3030 56 STC Paired Panels


Attachments: - Sketch SK-2 Dimension Floor Plan Detail

- Sketch LESK 01 Rail Modification & LESK 02 Rail Modification
- Breckon Land Design Addendum #2 1/29/25, (1 page), and (6) attached drawings.
  - SD3.0 Layout Plan
  - SD7.0 Utility Plan
  - SD7.5 Utility Details
  - SL1.0 Landscape Plan
  - SL2.0 Irrigation Plan
  - SL2.6 Irrigation Details
- Musgrove Engineering Mechanical Addendum #2 1/30/25, (1 page)
- Musgrove Engineering Electrical Addendum #2 1/30/25, (1 page)

- End of Addendum No. 2

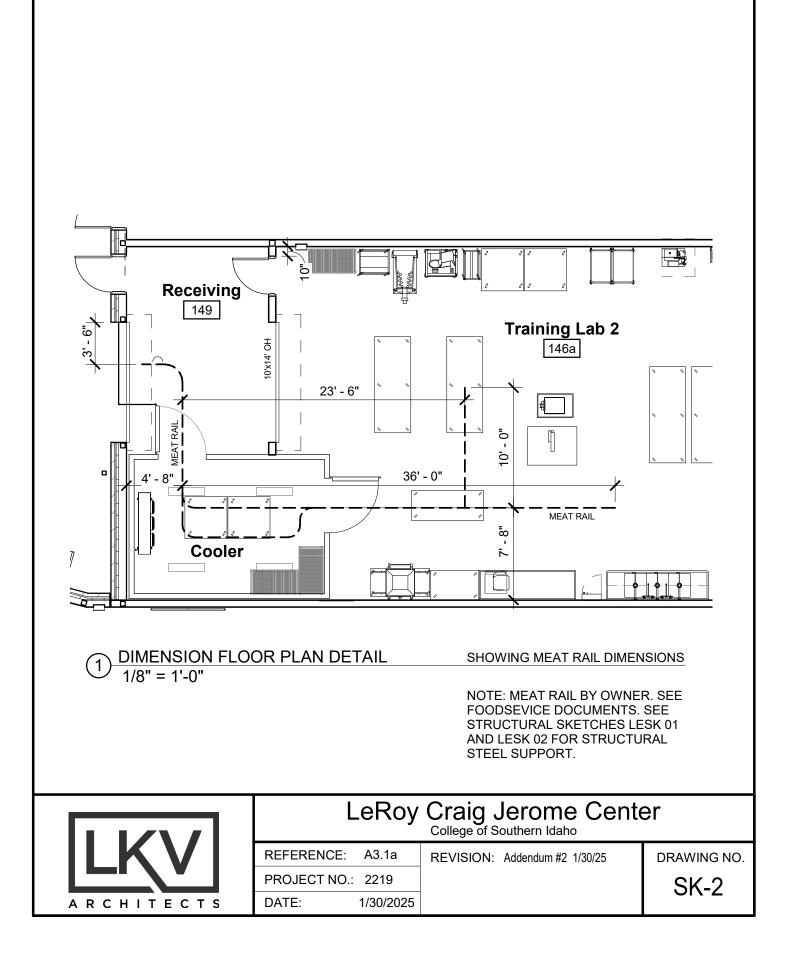

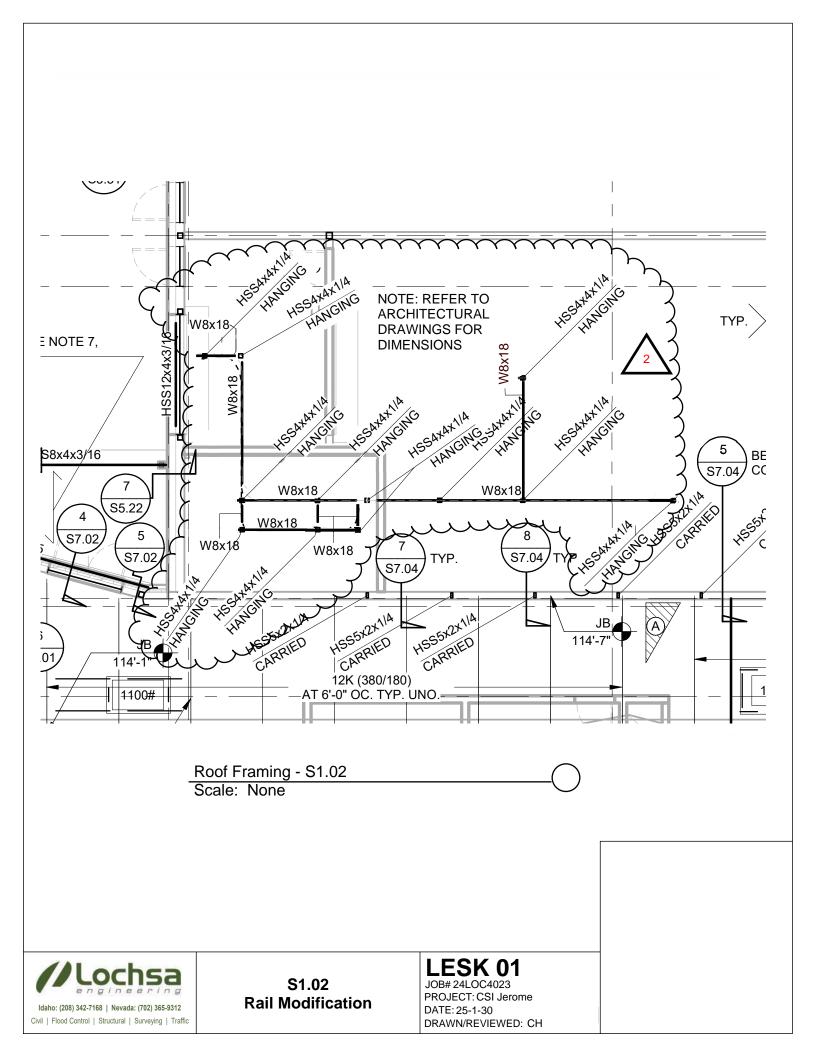

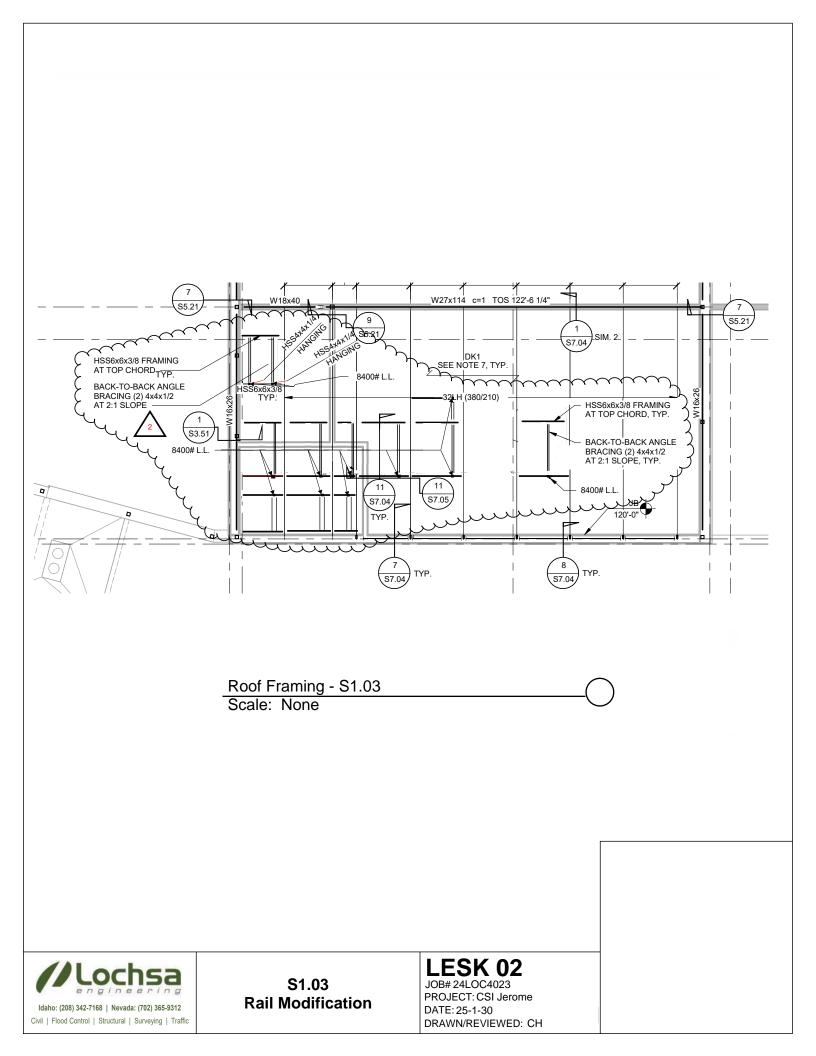



Landscape Architecture • Civil Engineering • Graphic Communication • Waterscape Design • Irrigation Design • Land Planning

## Addendum #2 – CSI LeRoy Craig Jerome Center

DATE:	1-29-2025	
TO:	Plan Holders	
FROM:	Jon Breckon, PLA	

This Addendum shall be acknowledged at the time of bidding and the contents included as part of the Bid Documents.

### GENERAL


1-1 Addendum #2 consists of \_7\_ total pages.

### DRAWINGS


- 1-2 Sheet SD2.0, Callout 4 revised to "Save and Protect existing water service, field verify existing conditions and meter size, see utility plan for more information." in lieu of removal
- 1-3 Sheet SD3.0, Callout 4 replaced with "Trash enclosure, see enlargement on sheet SD3.7"
- 1-4 Sheet SD3.0, Add 24 linear feet of detectable warning locations near the ADA parking stalls.
- 1-5 Sheet SD3.0, Revise ADA ramp style on the corner of Lincoln and 3<sup>rd</sup> Ave.
- 1-6 Sheet SD3.0, Revise tree grate locations along Lincoln Street
- 1-7 Sheet SD3.0, Revise callout 19 to specify the tree gate to be used.
- 1-8 Sheet SD3.0, Add callout 27, Steel Bollard locations.
- 1-9 Sheet SD3.5, Delete detail 9.
- 1-10 Sheet SD7.0, Replace sheet, per attached.
- 1-11 Sheet SD7.0 Replace callout 12 with "not used".
- 1-12 Sheet SD7.5, Add sheet with sewer profile and water meter vault detail.
- 1-13 Sheet SL1.0, Revise tree locations along Lincoln for adjusted tree grate locations.
- 1-14 Sheet SL1.0, Revise plant locations around water meter vault.
- 1-15 Sheet SL2.0, Revise irrigation schedule valve sizes.
- 1-16 Sheet SL2.0, Revise drip irrigation location at tree grate locations.
- 1-17 Sheet SL2.0, Revise Backflow preventer location.
- 1-18 Sheet SL2.0, Modify mainline size per plans.
- 1-19 Sheet SL2.6, Replace detail 1.

See attached sheets SD3.0, SD7.0, SD7.5, SL1.0, SL2.0, SL2.6



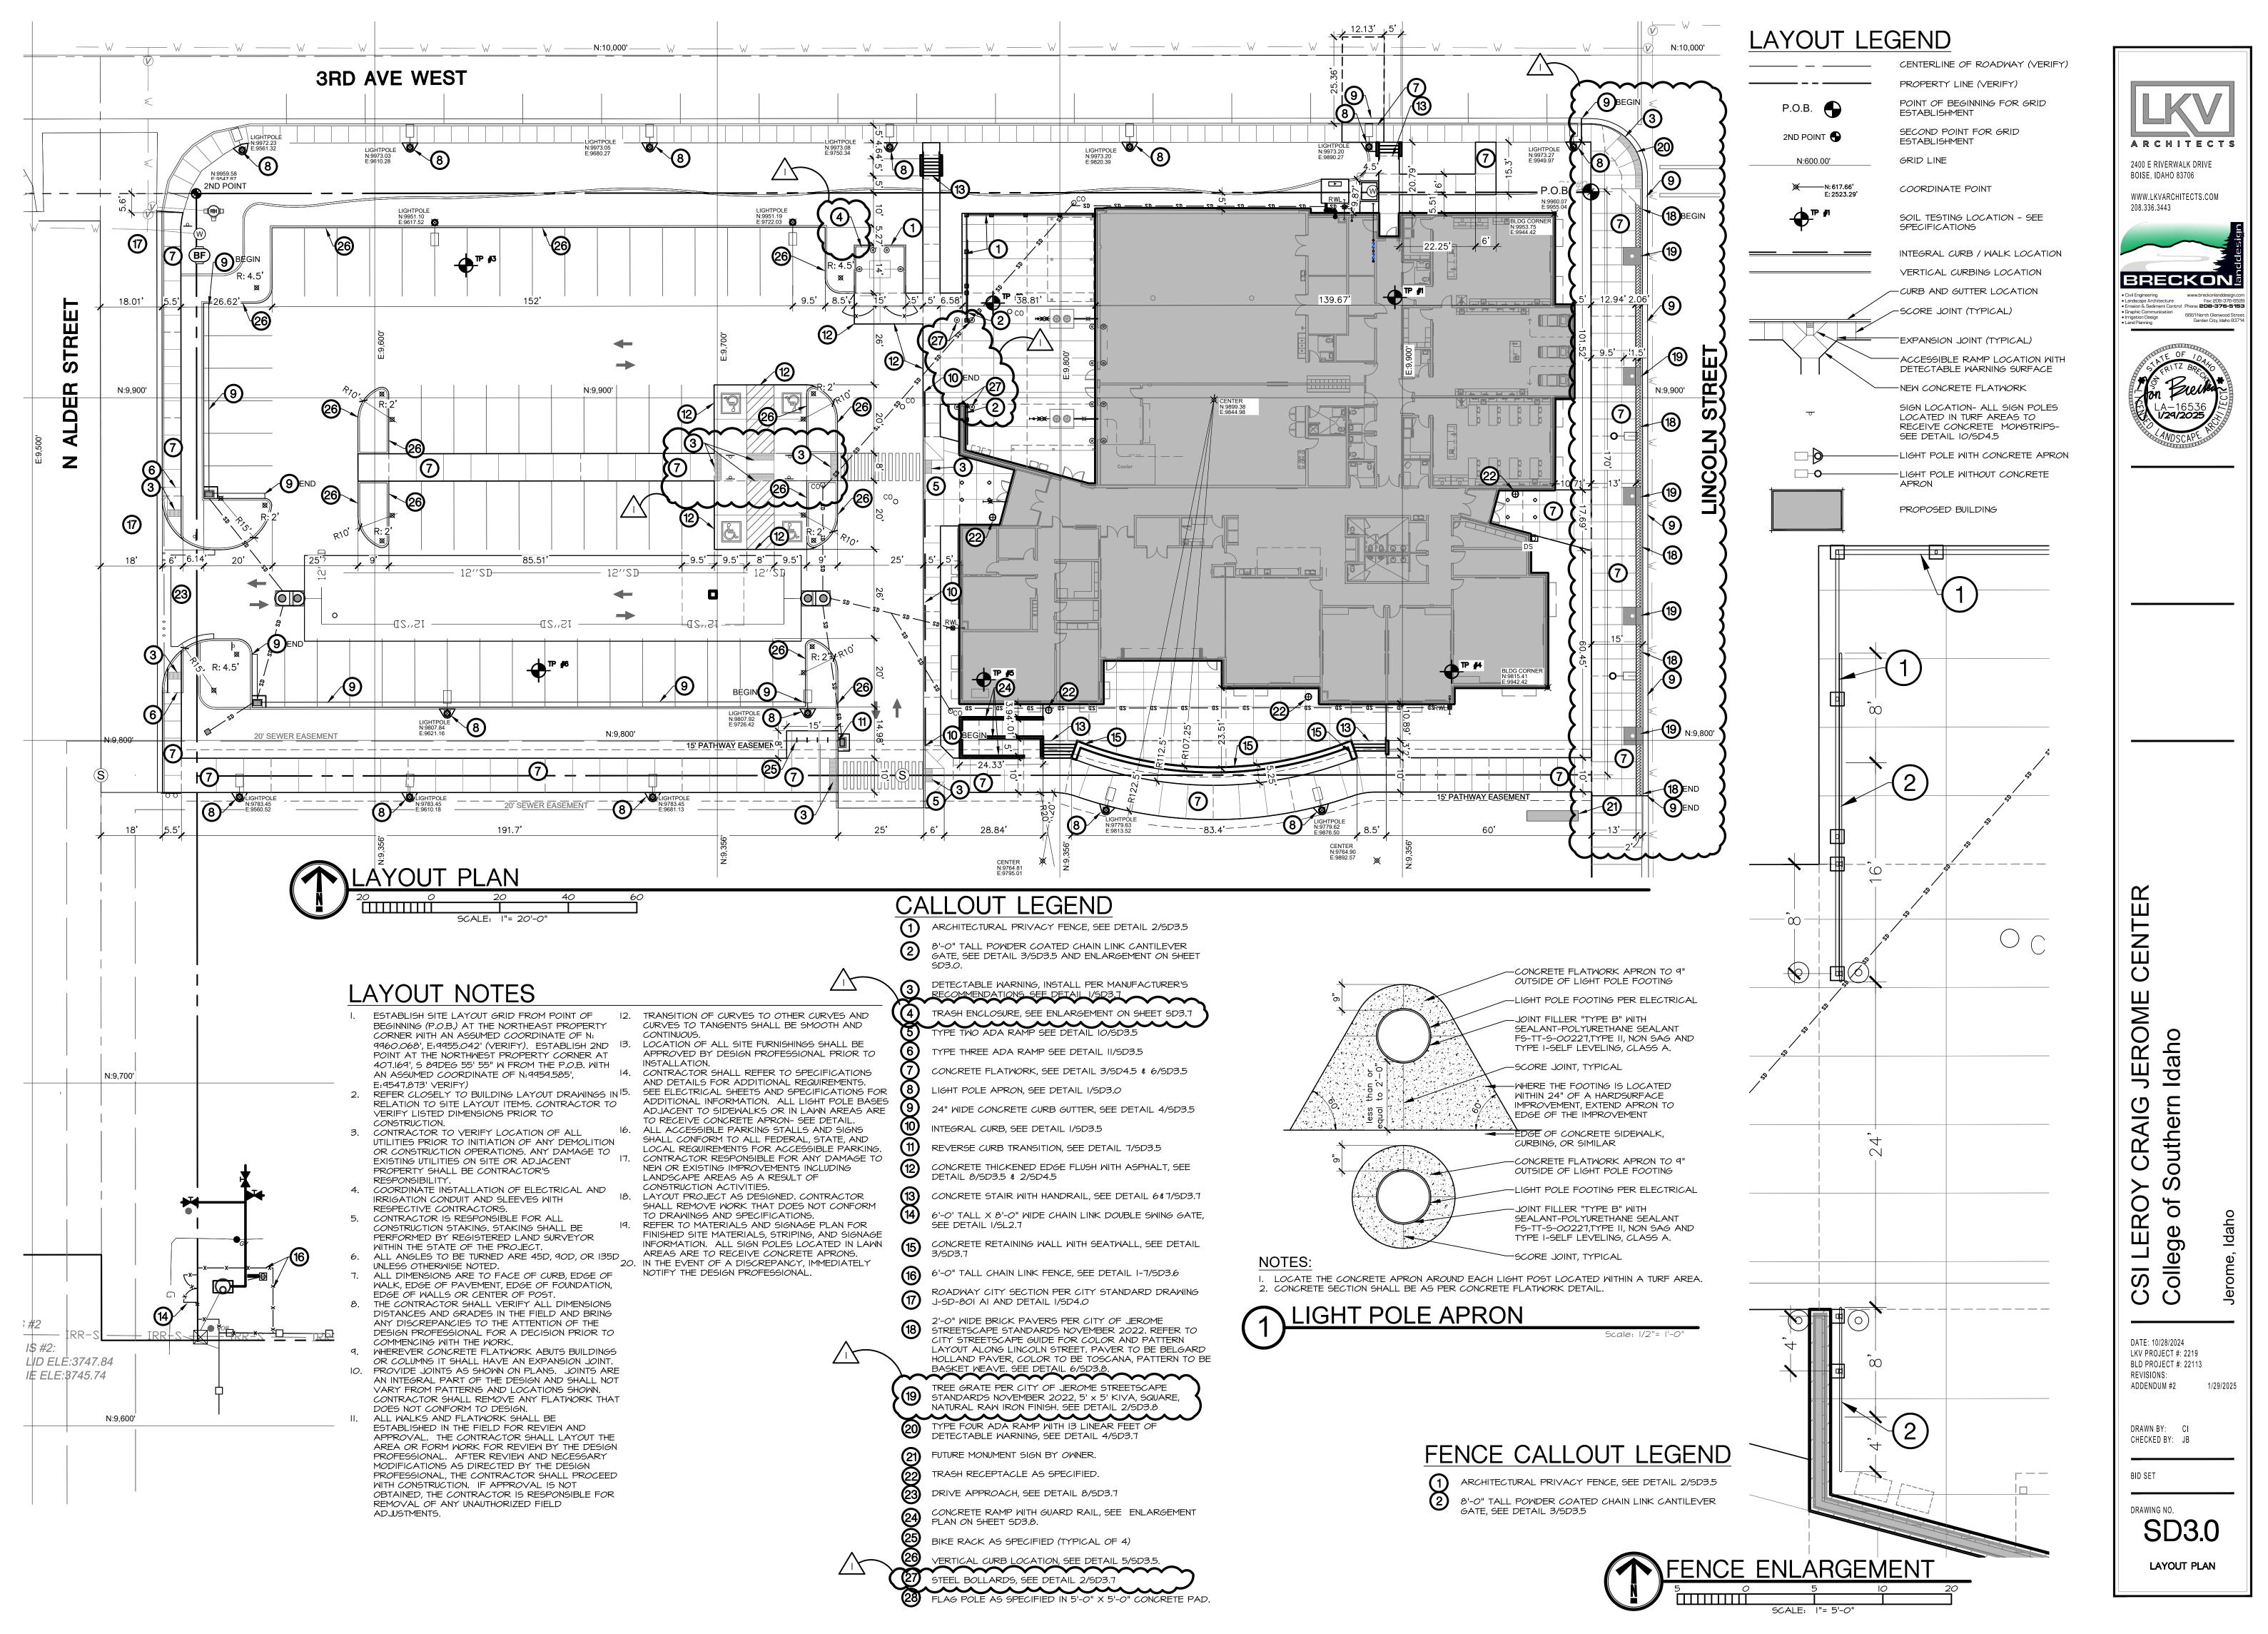




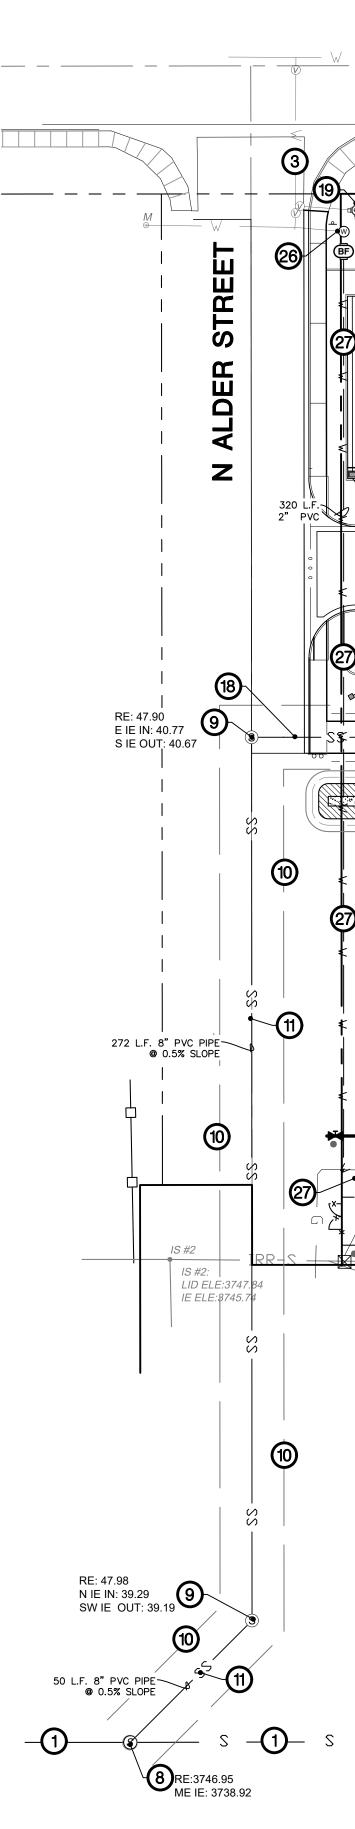


 $\overline{}$ 

-(20



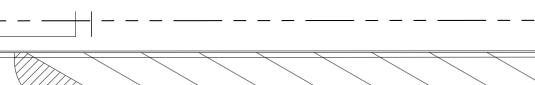

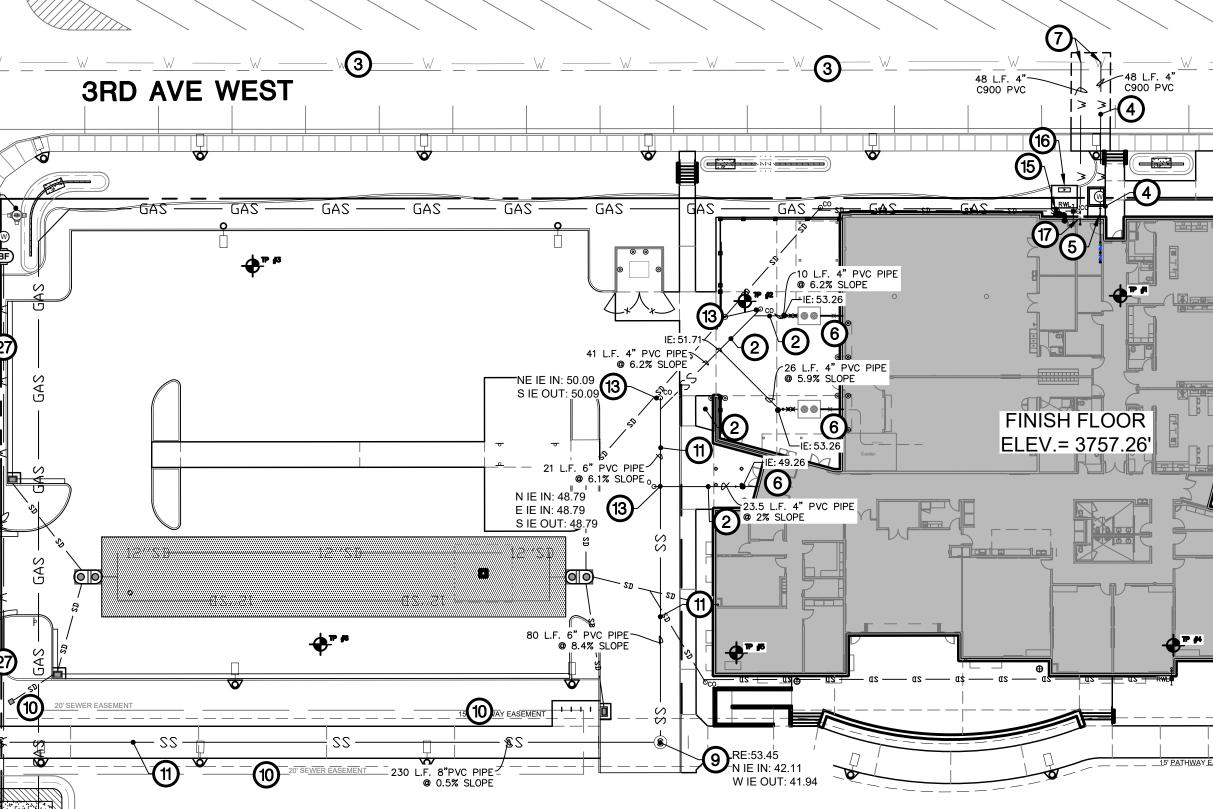

(<del>Maxo R</del>



# UTILITY GENERAL NOTES

- I. THE LOCATION OF EXISTING UNDERGROUND UTILITIES ARE SHOWN IN APPROXIMATE LOCATIONS. THE CONTRACTOR SHALL DETERMINE THE EXACT LOCATION OF ALL EXISTING UTILITIES PRIOR TO COMMENCING WORK AND AGREES TO BE FULLY RESPONSIBLE FOR ANY AND ALL DAMAGES WHICH MAY BE OCCASIONED BY HIS FAILURE TO EXACTLY LOCATE AND PRESERVE ANY AND ALL UNDERGROUND UTILITIES.
- 2. CONTRACTOR SHALL COORDINATE AND VERIFY ALL UTILITIES/BUILDING CONNECTION POINTS WITH MECHANICAL PLANS AND MECHANICAL CONTRACTOR PRIOR TO COMMENCING WORK.
- 3. ALL CONTRACTORS CONDUCTING UTILITIES WORK SHALL HAVE IN THEIR POSSESSION AT ALL TIMES, A COPY OF ALL RELEVANT SPECIFICATIONS.
- 4. CONTRACTOR SHALL NOTIFY THE ENGINEER OF RECORD OF ANY PLAN DISCREPANCIES PRIOR TO CONSTRUCTION. ANY PLAN CHANGES MUST BE APPROVED BY THE ENGINEER OF RECORD.
- 5. CALL DIGLINE PRIOR TO EXCAVATION: 811.
- 6. CONTRACTOR SHALL PROVIDE THE ENGINEER OF RECORD THE FOLLOWING AS BUILT INFORMATION FOR RECORD DRAWING PURPOSES: A. HORIZONTAL LOCATIONS OF SANITARY SEWER MANHOLES AND CLEANOUTS.
- B. RIM AND INVERT ELEVATIONS OF SANITARY SEWER MANHOLES AND CLEANOUTS.
- C. TYPES AND LENGTHS OF PIPES D. HORIZONTAL LOCATIONS OF FIRE HYDRANTS, DOMESTIC WATER VALVES AND
- DOMESTIC WATER METERS 7. POTABLE WATER LINE AND NON POTABLE WATER LINE CROSSINGS REQUIRE 18" OF VERTICAL SEPARATION DISTANCE FROM OUTSIDE WALL OF PIPES. CONTRACTOR MAY NEED TO INSTALL POTABLE WATER LINE GREATER THAN THE TYPICAL 4 FEET DEPTH TO MEET SEPARATION REQUIREMENTS. HOWEVER, THE CONTRACTOR SHALL NOT INSTALL POTABLE WATER LINE WITH GREATER THAN 60" COVER FROM TOP OF PIPE TO FINISHED
- GRADE. 8. EXISTING OVERHEAD POWER LINES SHALL BE RETAINED AND PROTECTED AS NEEDED TO MAINTAIN SERVICE TO ADJACENT PROPERTIES. THE CONTRACTOR SHALL COORDINATE WITH THE POWER COMPANY TO ABANDON OR RELOCATE ALL OTHER
- OVERHEAD POWER LINES AND POLES AS REQUIRED. 9. UTILITY INSTALLATION AND CONSTRUCTION SHALL BE PER THE CURRENT EDITION OF THE ISPWC.




	EXISTING PROPERTY LINE
W W	EXISTING WATER LINE
—— w —— w ——	PROPOSED WATER LINE
- <b>⊼</b> -	PROPOSED WATER TEE
۲	PROPOSED WATER VALVE
¥	PROPOSED WATER BLOW OFF VALVE
22	PROPOSED SANITARY SEWER SERVICE LINE
° co	SEWER LINE CLEAN OUT

----- GAS ------ GAS ----- NATURAL GAS LINE


# UTILITY CALLOUT

- AVE AND PROTECT EXISTING SANITARY SEWER MAINLINE. FIELD VERIFY EXACT LOCATION.
- 2 INSTALL 4" PVC GRAVITY SANITARY SEWER SERVICE LINE PER I.S.P.W.C. SD-511 AND JEROME PUBLIC WORKS DEPARTMENT. SEWER SERVICE MUST BE INSTALLED WITH A MINIMUM OF 1% SLOPE PER CURRENT PLUMBING CODE. SEE MECHANICAL, ELECTRICAL AND PLUMBING PLANS FOR CONTINUATION. NOTIFY DESIGN PROFESSIONAL OF ANY DISCREPANCIES.
- 3 SAVE AND PROTECT EXISTING WATER MAINLINE. FIELD VERIFY EXACT LOCATION.
- (4) INSTALL 4" COO DOMESTIC WATER SERVICE AND METER PER 2018 INTERNATIONAL PLUMBING CODE AND ISPWC STANDARD DRAWING SD-402- WITH METER VAULT PER DETAIL I/SD7.5. COORDINATE BUILDING CONNECTION WITH PLUMBING PLANS.
- 5 CONNECT 3" WATER SERVICE LINE TO DUILD THIS APPROXIMATE LOCATION. SEE MECHANICAL, ELECTRICAL AND PLUMBING PLANS FOR CONNECT 3" WATER SERVICE LINE TO BUILDING IN CONTINUATION.
- 6 CONNECT SANITARY SEWER SERVICE TO BUILDING IN THIS APPROXIMATE LOCATION. SEE PLANS FOR INVERT ELEVATION, NOTIFY DESIGN PROFESSIONAL OF ANY DISCREPANCIES. SEE MECHANICAL, ELECTRICAL AND PLUMBING PLANS FOR CONTINUATION.
- HOT TAP WATER SERVICE LINE TO THE EXISTING HOT TAP WATER SERVICE LINE TO THE EXISTING WATER MAIN IN THIS APPROXIMATE LOCATION. PROVIDE ALL MATERIALS TO ENSURE A WATER TIGHT AND FUNCTIONAL SEAL.
- CONNECT SANITARY SEWER MAINLINE TO EXISTING 8 SEWER MANHOLE IN THIS APPROXIMATE LOCATION PER CITY OF JEROME STANDARDS. CONTRACTOR TO FIELD VERIFY LOCATION AND INVERT ELEVATIONS.
- 9 SEWER MANHOLE WITH CONCRETE COLLAR. SEE PLANS FOR INVERT ELEVATIONS. REFER TO ISPWC SD-501, 507, 508 FOR STANDARD DETAILS.
- 20' SEWER EASEMENT
- INSTALL 8" PVC GRAVITY SANITARY SEWER MAINLINE PER I.S.P.W.C. SD-511 AND JEROME PUBLIC MAINLINE PER I.S.P.W.C. SD-511 AND JEROME PUBLIC WORKS DEPARTMENT. SEWER MUST BE INSTALLED WITH A MINIMUM OF 0.5% SLOPE PER CURRENT PLUMBING CODE. SEE MECHANICAL, ELECTRICAL AND PLUMBING PLANS FOR CONTINUATION. NOTIFY DESIGN PROFESSIONAL OF ANY DISCREPANCIES.
- (12) NOT USED.
- (3) CLEAN OUT LOCATION, SEE ISPWC SD-506 FOR STANDARD DETAIL.
- CONNECT NEW GAS LINE TO EXISTING GAS VALVE 14 IN THIS APPROXIMATE LOCATION. FIELD VERIFY EXACT LOCATION AND PROVIDE ALL MATERIALS FOR A FULLY FUNCTIONAL CONNECTION. COORDINATE WITH GAS COMPANY AS REQUIRED.
- 5 CONNECT NEW GAS LINE TO BUILDING IN THIS LOCATION. SEE MECHANICAL PLANS FOR ADDITIONAL INFORMATION.
- 16 TRANSFORMER LOCATION. SEE ELECTRICAL PLANS FOR ADDITIONAL INFORMATION AND REQUIREMENTS.
- CONNECT FIRE SPRINKLER LINE TO BUILDING IN THIS APPROXIMATE LOCATION. SEE MECHANICAL, ELECTRICAL AND PLUMBING PLANS FOR ELECTRICAL AND PLUMBING PLANS FOR CONTINUATION.
- (18) VERTICAL SEPARATION PER ISPWC SPECIFICATIONS AND SD-407.
- (19) SAVE AND PROTECT EXISTING FIRE HYDRANT
- (20) GAS SERVICE LINE PER LOCAL PURVEYOR
- (21) NOT USED
- CONNECT TO NEW WET WELL AND INSTALL FLOAT SWITCH FOR AUTOMATIC FILL. USE 2" DOMESTIC WATER SERVICE FOR ALTERNATE IRRIGATION WATER SOURCE. SUBMIT SHOP DRAWINGS FOR
- REVIEW AND APPROVAL PRIOR TO INSTALLATION. NOT USED
- NOT USED
- NOT USED
- PROVIDE AND INSTALL NEW 2" WATER METER AND SETTER PER ISPWC SD402 SETTER PER ISPWC SD402.
- W NEW 2" WATER SERVICE LINE

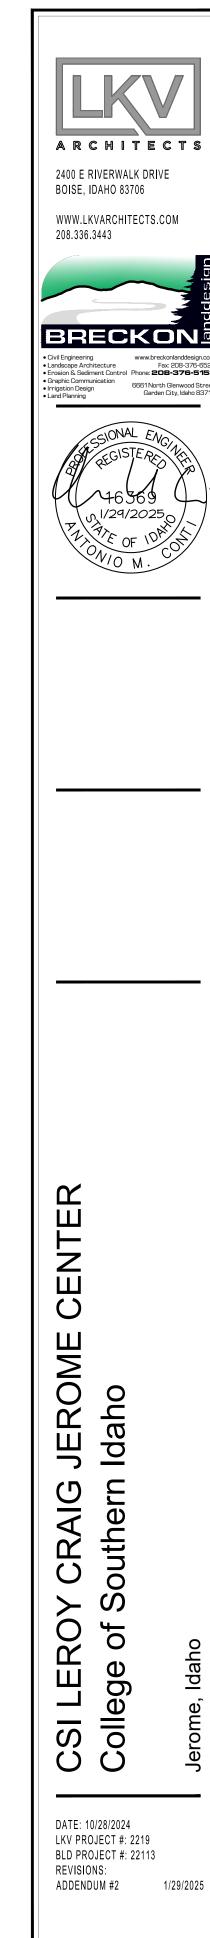

- DRAWN BY: CI CHECKED BY: JB
- BID SET



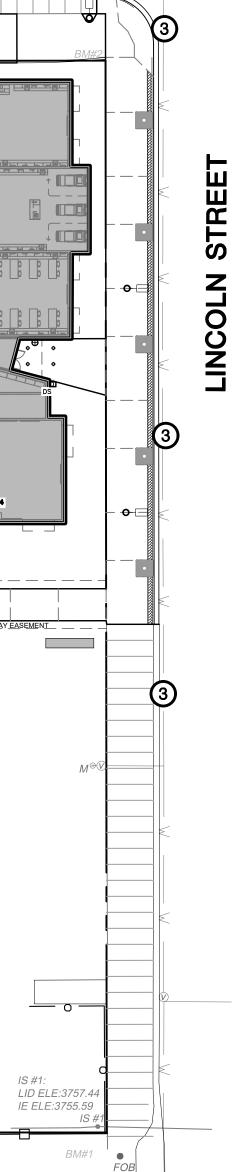

(19)

3







# LANDSCAPE NOTES:


- CONTRACTOR SHALL REPORT TO DESIGN PROFESSIONAL ALL CONDITIONS WHICH IMPAIR AND/OR PREVENT THE PROPER EXECUTION OF THIS WORK, PRIOR TO BEGINNING WORK. NO MATERIAL SUBSTITUTIONS SHALL BE MADE WITHOUT THE DESIGN
- PROFESSIONAL'S PRIOR WRITTEN APPROVAL. ALTERNATE MATERIALS OF SIMILAR SIZE AND CHARACTER MAY BE CONSIDERED IF SPECIFIED PLANT MATERIALS CAN NOT BE OBTAINED. COORDINATE ALL WORK WITH ALL OTHER SITE RELATED DEVELOPMENT
- DRAWINGS. COORDINATE WORK SCHEDULE AND OBSERVATIONS WITH DESIGN
- PROFESSIONAL PRIOR TO CONSTRUCTION START-UP. ALL PLANT MATERIAL SHALL BE INSTALLED AS PER DETAILS.
- ALL PLANT MATERIAL SHALL CONFORM TO THE AMERICAN NURSERYMAN STANDARDS FOR TYPE AND SIZE SHOWN. PLANTS WILL BE REJECTED IF NOT IN A SOUND AND HEALTHY CONDITION.
- IN THE EVENT OF A PLANT COUNT DISCREPANCY, PLANT SYMBOLS SHALL OVERRIDE SCHEDULE QUANTITIES AND CALL OUT SYMBOL NUMBERS. ALL PLANTING BEDS SHALL BE COVERED WITH A MINIMUM OF 3" DEPTH OF 8.
- LARGE (2" MINUS) CRUSHED BASALT MULCH. SUBMIT SAMPLE FOR APPR*o*val
- 9. ALL PLANT MATERIAL SHALL BE GUARANTEED FOR A PERIOD OF ONE YEAR BEGINNING AT THE DATE OF ACCEPTANCE BY THE OWNER. REPLACE ALL PLANT MATERIAL FOUND DEAD OR NOT IN A HEALTHY CONDITION IMMEDIATELY WITH THE SAME SIZE AND SPECIES AT NO COST TO THE OWNER
- IO. FINISH GRADES SHALL PROVIDE A SMOOTH TRANSITION WITH ADJACENT SURFACES AND ENSURE POSITIVE DRAINAGE IN ACCORDANCE WITH THE SITE GRADING PLAN.
- AMEND EXISTING APPROVED TOPSOIL AT A RATIO OF THREE CUBIC YARDS OF APPROVED COMPOST PER 1000 SQUARE FEET. ROTO-TILL ORGANIC MATTER A MINIMUM OF 6 INCHES INTO TOPSOIL 12. FERTILIZE ALL TREES AND SHRUBS WITH 'AGRIFORM' PLANTING TABLETS.
- QUANTITY PER MANUFACTURER'S RECOMMENDATIONS. 13. ALL PLANTING BEDS SHALL HAVE A MINIMUM 18" DEPTH OF TOPSOIL. LAWN AREAS SHALL HAVE A MINIMUM 12" DEPTH OF TOPSOIL. SPREAD, COMPACT, AND FINE GRADE TOPSOIL TO A SMOOTH AND UNIFORM GRADE 3" BELOW ADJACENT SURFACES OF PLANTER BED AREAS, I-I/2" BELOW
- ADJACENT SURFACES OF TURF SOD AREAS, AND I" BELOW ADJACENT SURFACES OF TURF SEED AREAS. 14. REUSE EXISTING TOPSOIL STOCKPILED ON THE SITE. SUPPLEMENT WITH IMPORTED TOPSOIL WHEN QUANTITIES ARE INSUFFICIENT. VERIFY SUITABILITY AND CONDITION OF TOPSOIL AS A GROWING MEDIUM. PERFORM SOIL TEST/ ANALYSIS AND PROVIDE ADDITIONAL AMENDMENT AS DETERMINED BY SOIL TESTS. TOPSOIL SHALL BE A LOOSE, FRIABLE, SANDY LOAM, CLEAN AND FREE OF TOXIC MATERIALS, NOXIOUS WEEDS, WEED SEEDS, ROCKS, GRASS OR OTHER FOREIGN MATERIAL AND A HAVE A PH OF 5.5 TO 7.0. IF ONSITE TOPSOIL DOES NOT MEET THESE MINIMUM STANDARDS, CONTRACTOR IS RESPONSIBLE TO EITHER:
- A) PROVIDE APPROVED IMPORTED TOPSOIL, OR B) IMPROVE ON-SITE TOPSOIL WITH METHODS APPROVED BY THE DESIGN PROFESSIONAL
- 15. IF IMPORTED TOPSOIL FROM OFF-SITE SOURCES IS REQUIRED, ENSURE IT IS FERTILE, FRIABLE, NATURAL LOAM, SURFACE SOIL, REASONABLY FREE OF SUBSOIL, CLAY LUMPS, BRUSH, WEEDS AND OTHER LITTER, AND FREE OF ROOTS, STUMPS, STONES LARGER THAN 2 INCHES IN ANY DIMENSION, AND OTHER EXTRANEOUS OR TOXIC MATTER HARMFUL TO PLANT GROWTH. A) OBTAIN TOPSOIL FROM LOCAL SOURCES OR FROM AREAS HAVING SIMILAR SOIL CHARACTERISTICS TO THOSE FOUND ON THE PROJECT SITE. OBTAIN TOPSOIL ONLY FROM NATURALLY, WELL-DRAINED SITES WHERE TOPSOIL OCCURS AT A DEPTH OF NOT LESS THAN 4 INCHES. B) REPRESENTATIVE SAMPLES SHALL BE TESTED FOR ACIDITY, FERTILITY, TOXICITY, AND GENERAL TEXTURE BY A RECOGNIZED COMMERCIAL OR GOVERNMENT AGENCY AND COPIES OF THE TESTING AGENCY'S FINDINGS AND RECOMMENDATIONS SHALL BE FURNISHED TO THE OWNER'S REPRESENTATIVE BY THE CONTRACTOR. NO TOPSOIL SHALL BE DELIVERED IN A FROZEN OR MUDDY CONDITION. ACIDITY/ALKALINITY RANGE - PH. 5.5 TO 7.0.
- 16. IMMEDIATELY CLEAN UP ANY TOPSOIL OR OTHER DEBRIS ON THE SITE CREATED FROM LANDSCAPE OPERATIONS AND DISPOSE OF PROPERLY OFF SITE.
- 17. ANY PERENNIAL TREES OR PLANTS THAT WILL EXTEND ROOTS DEEPER THAN 18" SHALL BE PROHIBITED OVER UNDERGROUND SEEPAGE BEDS, INFILTRATION FACILITIES OR PIPING SYSTEMS.
- 18. <u>SEEPAGE BEDS AND OTHER</u> STORM DRAINAGE FACILITIES MUST BE PROTECTED FROM ANY AND ALL CONTAMINATION DURING THE CONSTRUCTION AND INSTALLATION OF THE LANDSCAPE IRRIGATION
- 19. IN THE EVENT OF A DISCREPANCY, NOTIFY THE DESIGN PROFESSIONAL IMMEDIATELY.

# LANDSCAPE AREA **PREPARATION NOTES:**

- LIMIT TURF SUBGRADE PREPARATION TO AREAS TO BE PLANTED. NEWLY GRADED SUBGRADES: LOOSEN SUBGRADE TO A MINIMUM DEPTH OF 4 INCHES. REMOVE STONES LARGER THAN I INCH IN ANY DIMENSION AND STICKS, ROOTS, RUBBISH, AND OTHER EXTRANEOUS MATTER AND LEGALLY DISPOSE OF THEM OFF OWNER'S PROPERTY.
- A. SPREAD PLANTING SOIL TO A DEPTH OF 12 INCHES IN TURF AREAS AND 18 INCHES AT SHRUB BED AREAS BUT NOT LESS THAN REQUIRED TO MEET FINISH GRADES AFTER LIGHT ROLLING AND NATURAL SETTLEMENT. DO NOT SPREAD IF PLANTING SOIL OR SUBGRADE IS FROZEN, MUDDY, OR EXCESSIVELY WET.
- SPREAD PLANTING SOIL OVER LOOSENED SUBGRADE. REDUCE ELEVATION OF PLANTING SOIL TO ALLOW FOR SOIL THICKNESS OF SOD OR SEED.
- 3. UNCHANGED SUBGRADES: IF TURF IS TO BE PLANTED IN AREAS UNALTERED OR UNDISTURBED BY EXCAVATING, GRADING, OR SURFACE-SOIL STRIPPING OPERATIONS, PREPARE SURFACE SOIL AS FOLLOWS:
- A. REMOVE EXISTING GRASS, VEGETATION, AND TURF. DO NOT MIX INTO SURFACE SOIL.
- LOOSEN SURFACE SOIL TO A DEPTH OF AT LEAST 6 INCHES. PROVIDE WEED ABATEMENT PROCEDURE. APPLY SOIL AMENDMENTS AND FERTILIZERS ACCORDING TO PLANTING SOIL MIX PROPORTIONS AND MIX THOROUGHLY INTO TOP 6 INCHES OF SOIL. TILL SOIL TO A HOMOGENEOUS MIXTURE OF FINE TEXTURE.
- C. APPLY SOIL AMENDMENTS DIRECTLY TO SURFACE SOIL BEFORE LOOSENING. D. REMOVE STONES LARGER THAN I INCH IN ANY DIMENSION AND STICKS,
- ROOTS, TRASH, AND OTHER EXTRANEOUS MATTER. E. LEGALLY DISPOSE OF WASTE MATERIAL, INCLUDING GRASS, VEGETATION, AND TURF, OFF OWNER'S PROPERTY.
- 4. FINISH GRADING: GRADE PLANTING AREAS TO A SMOOTH, UNIFORM SURFACE PLANE WITH LOOSE, UNIFORMLY FINE TEXTURE. GRADE TO WITHIN PLUS OR MINUS 1/2 INCH OF FINISH ELEVATION. ROLL AND RAKE, REMOVE RIDGES, AND FILL DEPRESSIONS TO MEET FINISH GRADES. LIMIT FINISH GRADING TO AREAS THAT CAN BE PLANTED IN THE IMMEDIATE FUTURE.
- MOISTEN PREPARED AREA BEFORE PLANTING IF SOIL IS DRY. WATER 5. THOROUGHLY AND ALLOW SURFACE TO DRY BEFORE PLANTING. DO NOT CREATE MUDDY SOIL.
- BEFORE PLANTING, OBTAIN DESIGN PROFESSIONAL'S ACCEPTANCE OF FINISH GRADING; RESTORE PLANTING AREAS IF ERODED OR OTHERWISE DISTURBED AFTER FINISH GRADING. 7. DO NOT SOW IMMEDIATELY FOLLOWING RAIN, OR WHEN GROUND IS TOO
- DRY. TEMPERATURE SHALL BE BETWEEN 55 F AND 95 F FOR A 24 HOUR PERIOD. WIND SHALL BE LESS THAN 5 MPH.

# WEED ABATEMENT NOTES:


- ALL AREAS TO BE PLANTED OR HYDROSEEDED SHALL HAVE WEED ABATEMENT OPERATIONS PERFORMED ON THEM PRIOR TO PLANTING OR HYDROSEEDING. 2. CONTRACTOR SHALL SPRAY ALL EXPOSED WEEDS WITH @ROUND-UPA
- (CONTACT HERBICIDE) OR APPROVED EQUAL. 3. DO NOT WATER FOR AT LEAST SEVEN (7) DAYS. REMOVE EXPOSED
- WEEDS FROM THE SITE. 4. CONTRACTOR SHALL OPERATE THE AUTOMATIC IRRIGATION SYSTEM FOR A PERIOD OF FOURTEEN (14) DAYS. AT CONCLUSION OF THIS WATERING PERIOD, DISCONTINUE WATERING FOR THREE TO FIVE (3-5) DAYS.
- 5. APPLY SECOND APPLICATION OF @ROUND-UPA TO ALL EXPOSED WEEDS. APPLY IN STRICT CONFORMANCE WITH MANUFACTURER'S SPECIFICATIONS AND INSTRUCTIONS. DO NOT WATER FOR AT LEAST SEVEN (7) DAYS. REMOVE WEEDS FROM THE SITE. 6. IF ANY EVIDENCE OF WEED GERMINATION EXISTS AFTER TWO (2)
- APPLICATIONS, CONTRACTOR SHALL BE DIRECTED TO PERFORM A THIRD APPLICATION.
- 7. AT THE TIME OF PLANTING AND HYDROSEEDING, ALL PLANTING AREAS SHALL BE WEED FREE.

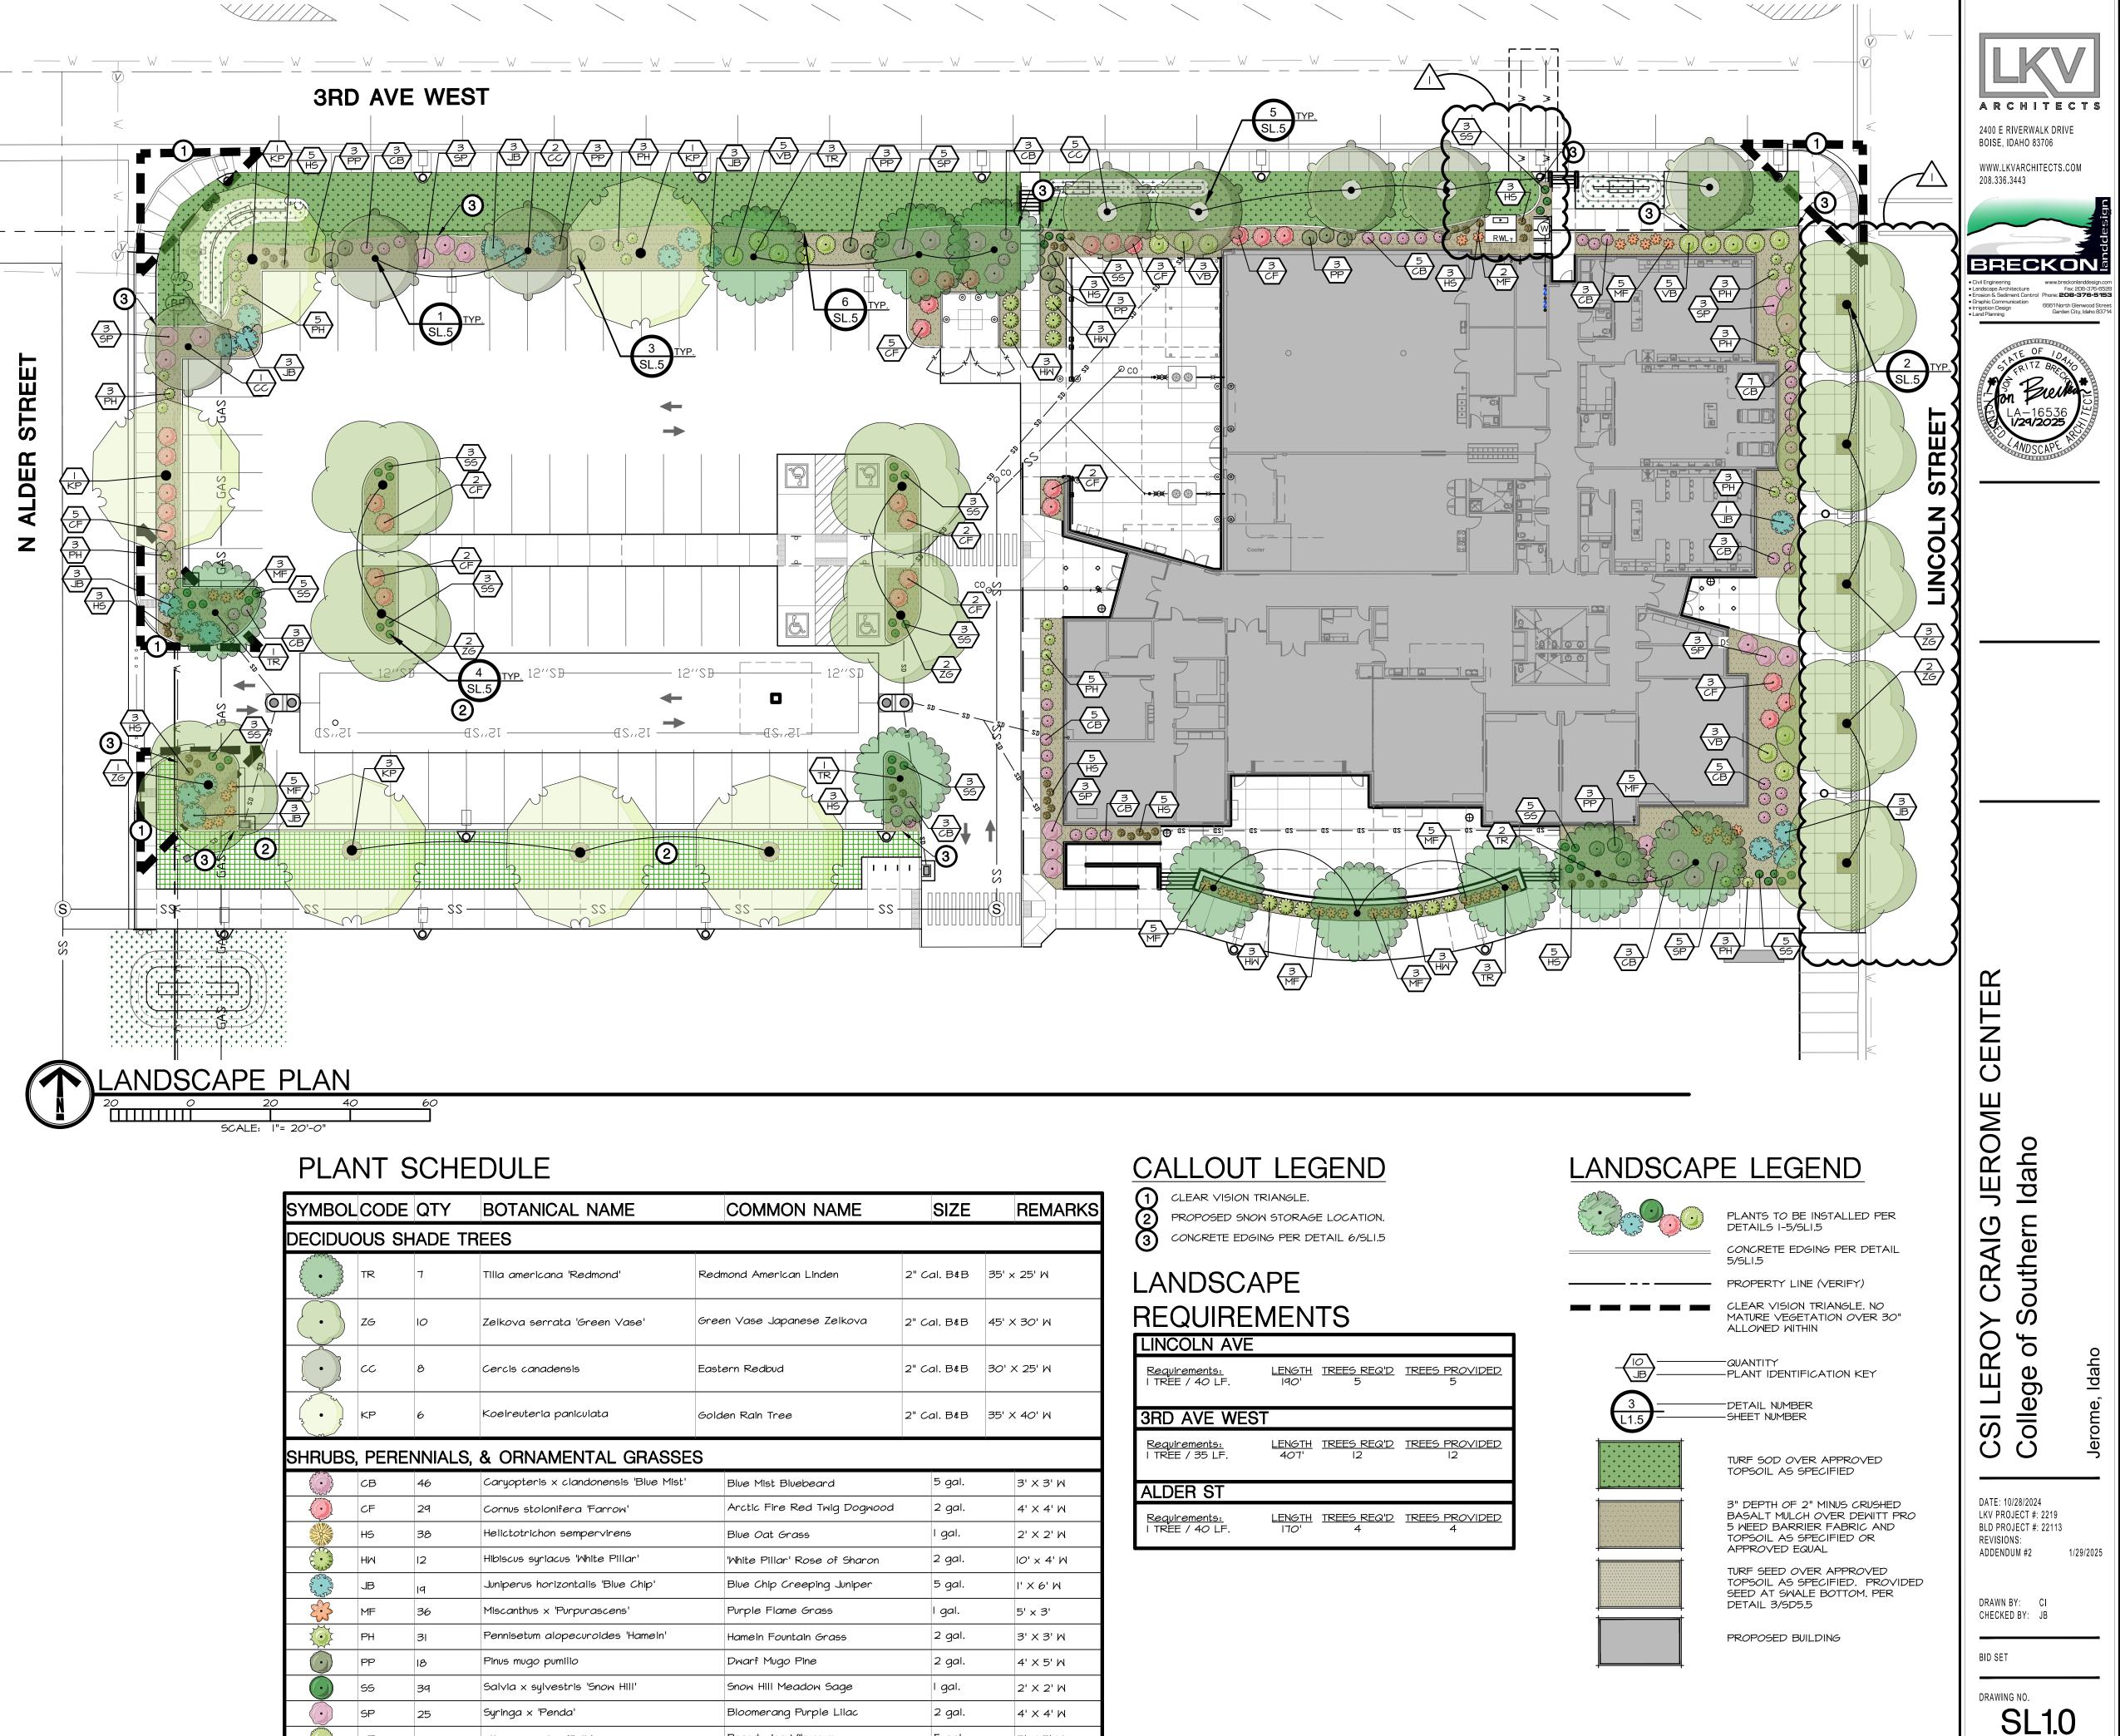






MBOL	CODE	QTY	BOTANICAL NAME	COMMON NAME	SIZE	REMARK
	SUS S⊦	IADE TF	REES			
•	TR	٦	Tilia americana 'Redmond'	Redmond American Linden	2" Cal. B&B	35' x 25' W
	ZG	10	Zelkova serrata 'Green Vase'	Green Vase Japanese Zelkova	2" Cal. B\$B	45' X 30' W
	сс	8	Cercis canadensis	Eastern Redbud	2" Cal. B¢B	30' X 25' M
•	KP	6	Koelreuteria paniculata	Golden Rain Tree	2" Cal. B¢B	35' X 40' M
RUBS	, PEREI	NNIALS,	& ORNAMENTAL GRASSE	ES .		
	СВ	46	Caryopteris x clandonensis 'Blue Mist'	Blue Mist Bluebeard	5 gal.	3' X 3' M
Ó	CF	29	Cornus stolonifera 'Farrow'	Arctic Fire Red Twig Dogwoo	d 2 gal.	4' X 4' M
	HS	38	Helictotrichon sempervirens	Blue Oat Grass	l gal.	2' X 2' M
in the second second	нм	12	Hibiscus syriacus 'White Pillar'	'White Pillar' Rose of Sharon	2 gal.	10' × 4' W
5.5°	JB	19	Juniperus horizontalis 'Blue Chip'	Blue Chip Creeping Juniper	5 gal.	I' X 6' M
2	MF	36	Miscanthus x 'Purpurascens'	Purple Flame Grass	l gal.	5' × 3'
w			Pennisetum alopecuroides 'Hameln'	Hameln Fountain Grass	2 gal.	3' X 3' W
	PH	31				
	PH PP	31 18	Pinus mugo pumilio	Dwarf Mugo Pine	2 gal.	4' X 5' W
			·		2 gal. I gal.	4' X 5' W 2' X 2' W
M.	PP	18	Pinus mugo pumilio	Dwarf Mugo Pine	-	

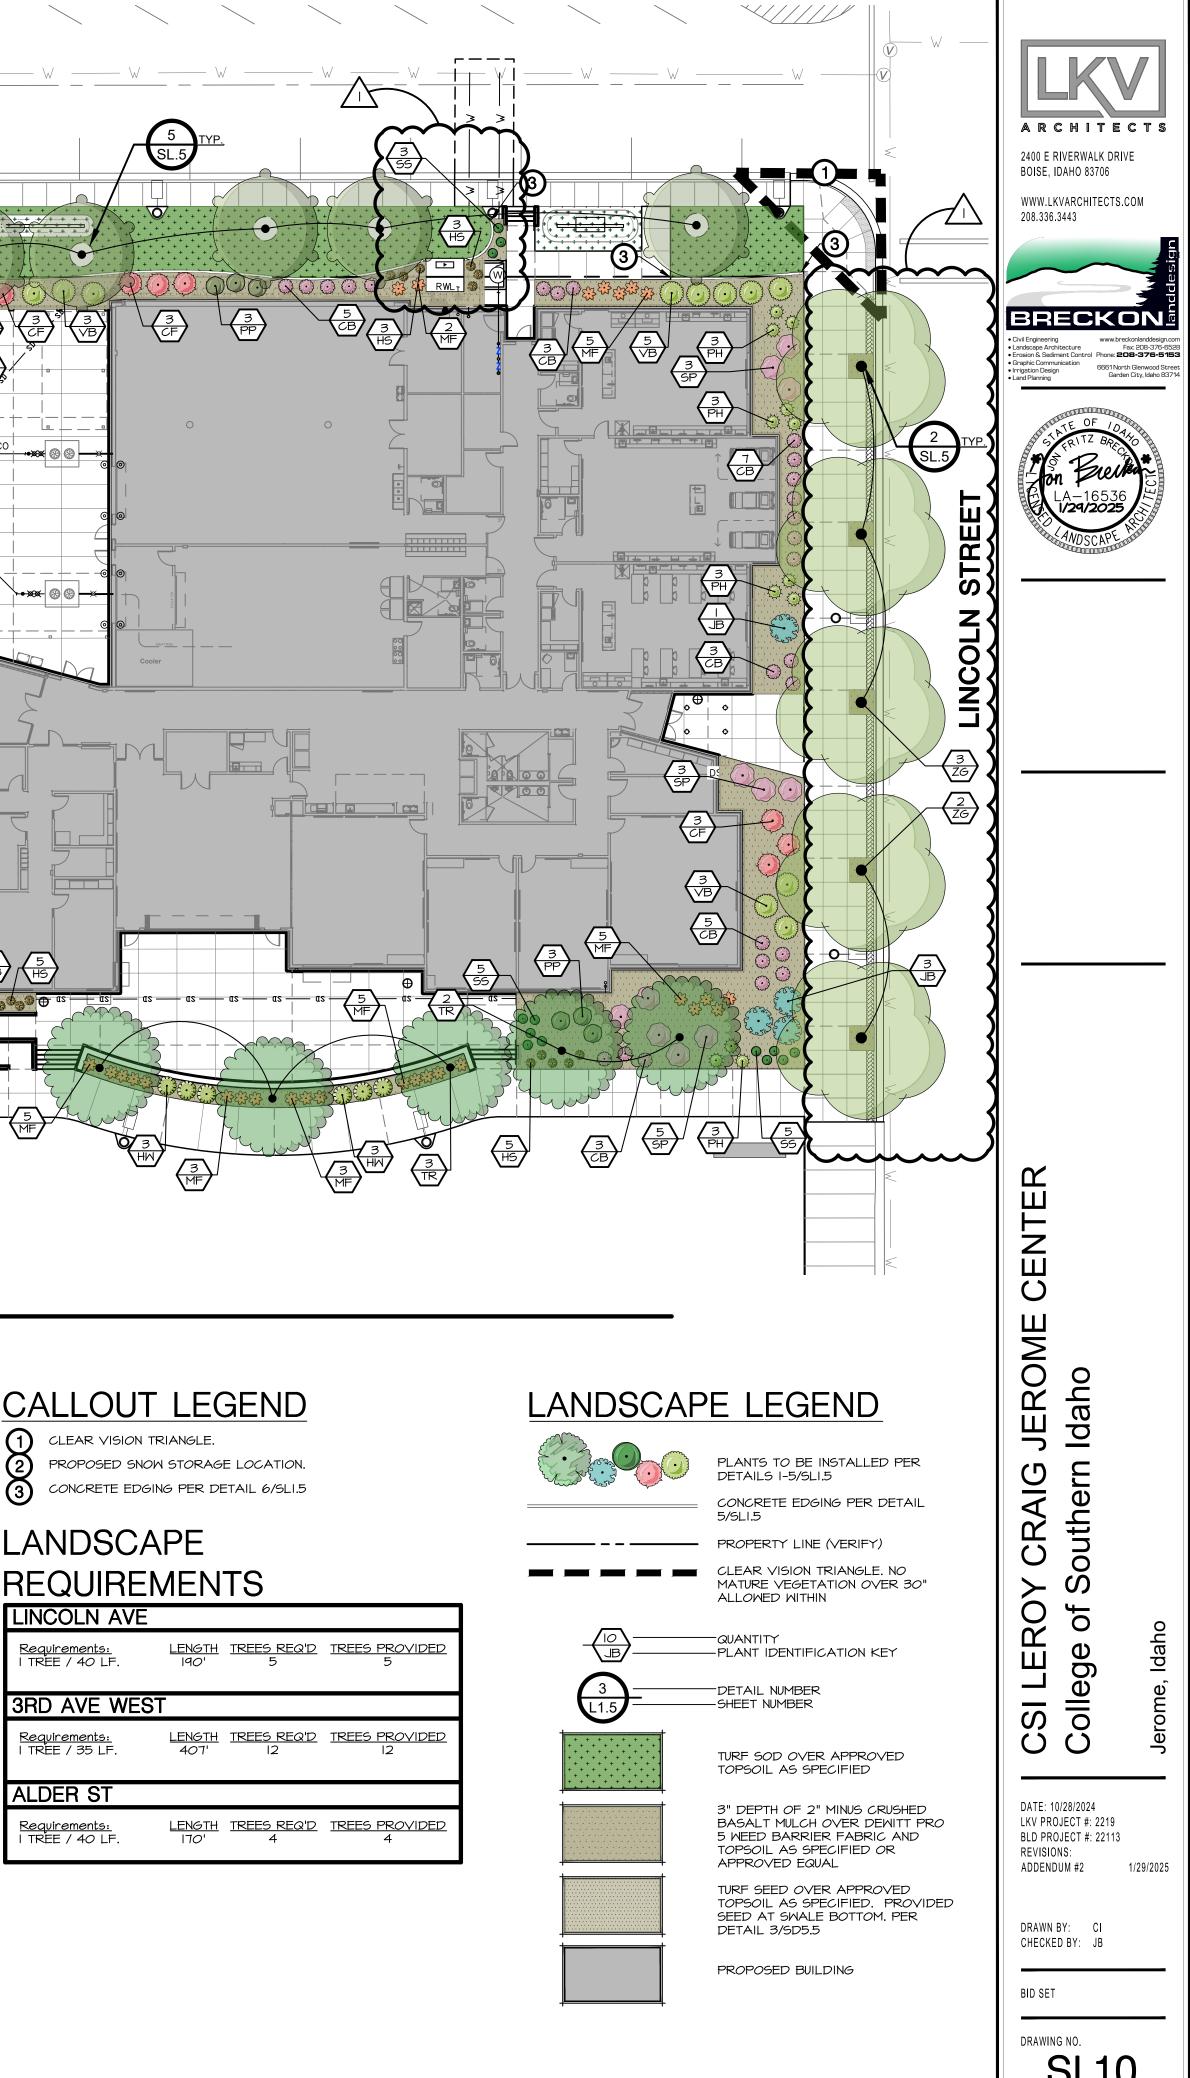


LANDSCAPE

PLAN

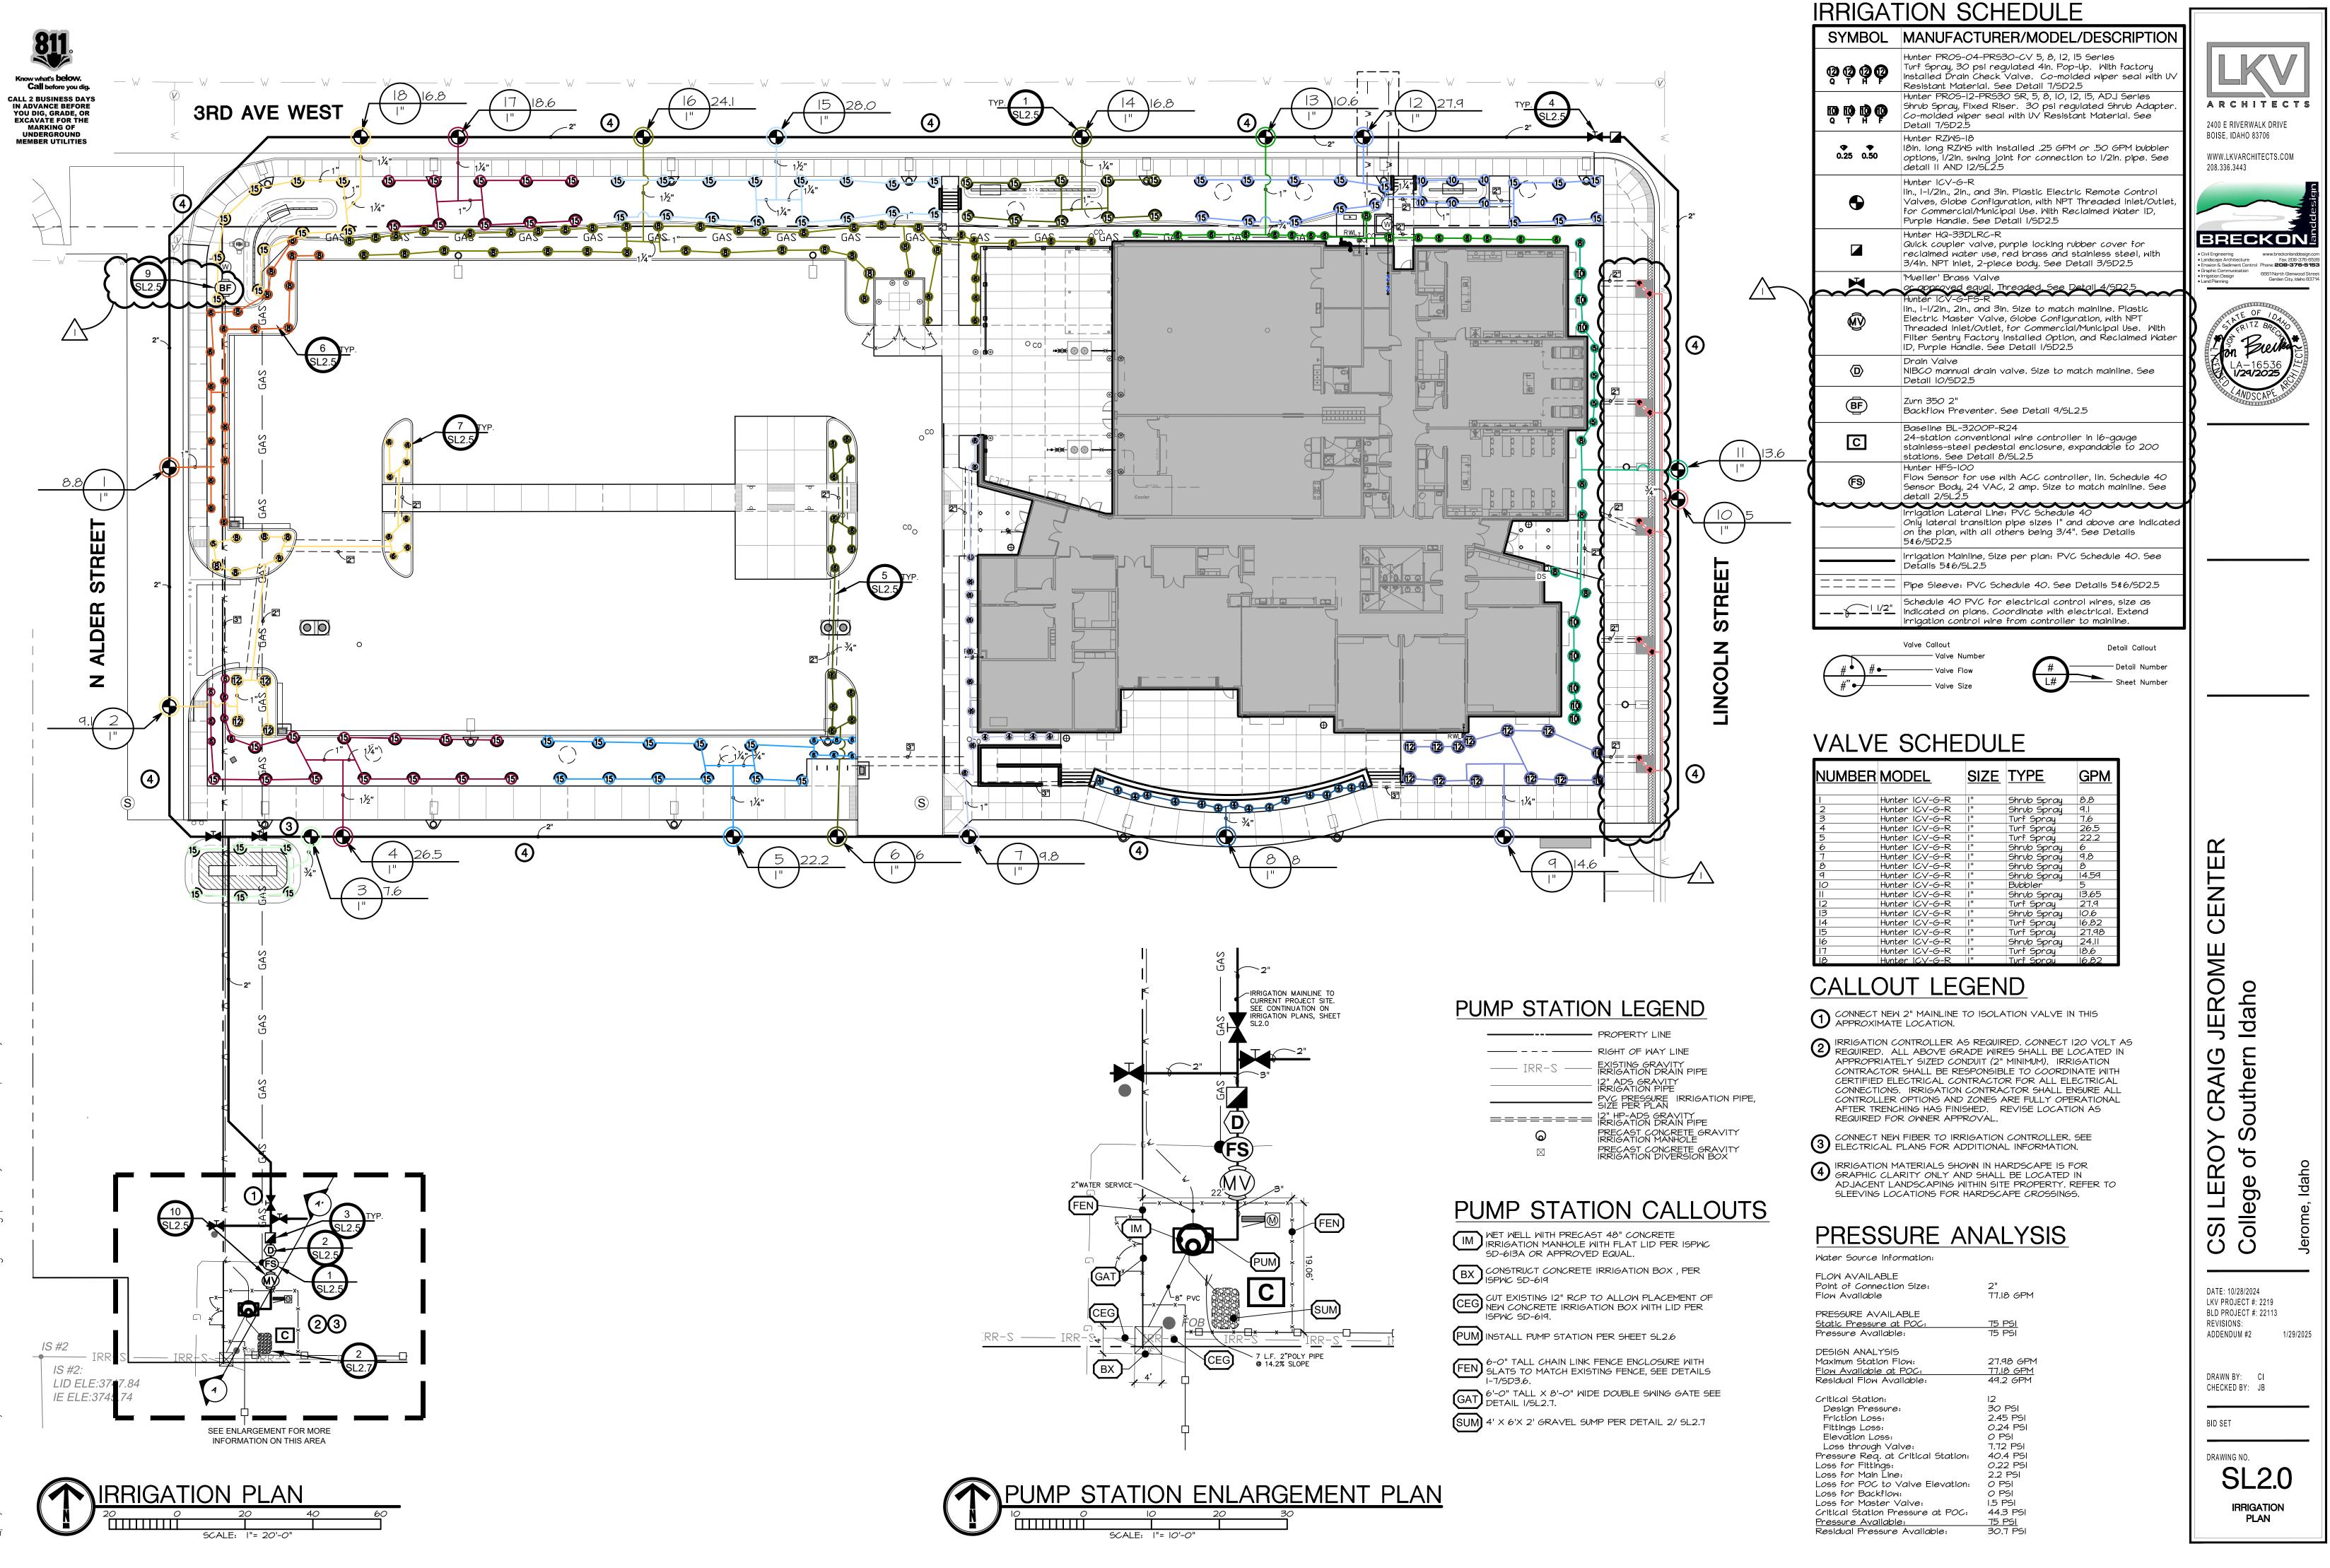



	IRRIGATION MANHOLE WITH FLAT SD-613A OR APPROVED EQUAL.
BX	CONSTRUCT CONCRETE IRRIGAT
CEG	CUT EXISTING 12" RCP TO ALLON NEW CONCRETE IRRIGATION BOX ISPWC SD-619.
PUM	INSTALL PUMP STATION PER SHE
	6-0" TALL CHAIN LINK FENCE EI SLATS TO MATCH EXISTING FENG I-7/SD3.6.
GAT	6'-0" TALL X 8'-0" WIDE DOUBL DETAIL I/SL2.7.
SUM	4' X 6'X 2' GRAVEL SUMP PER D

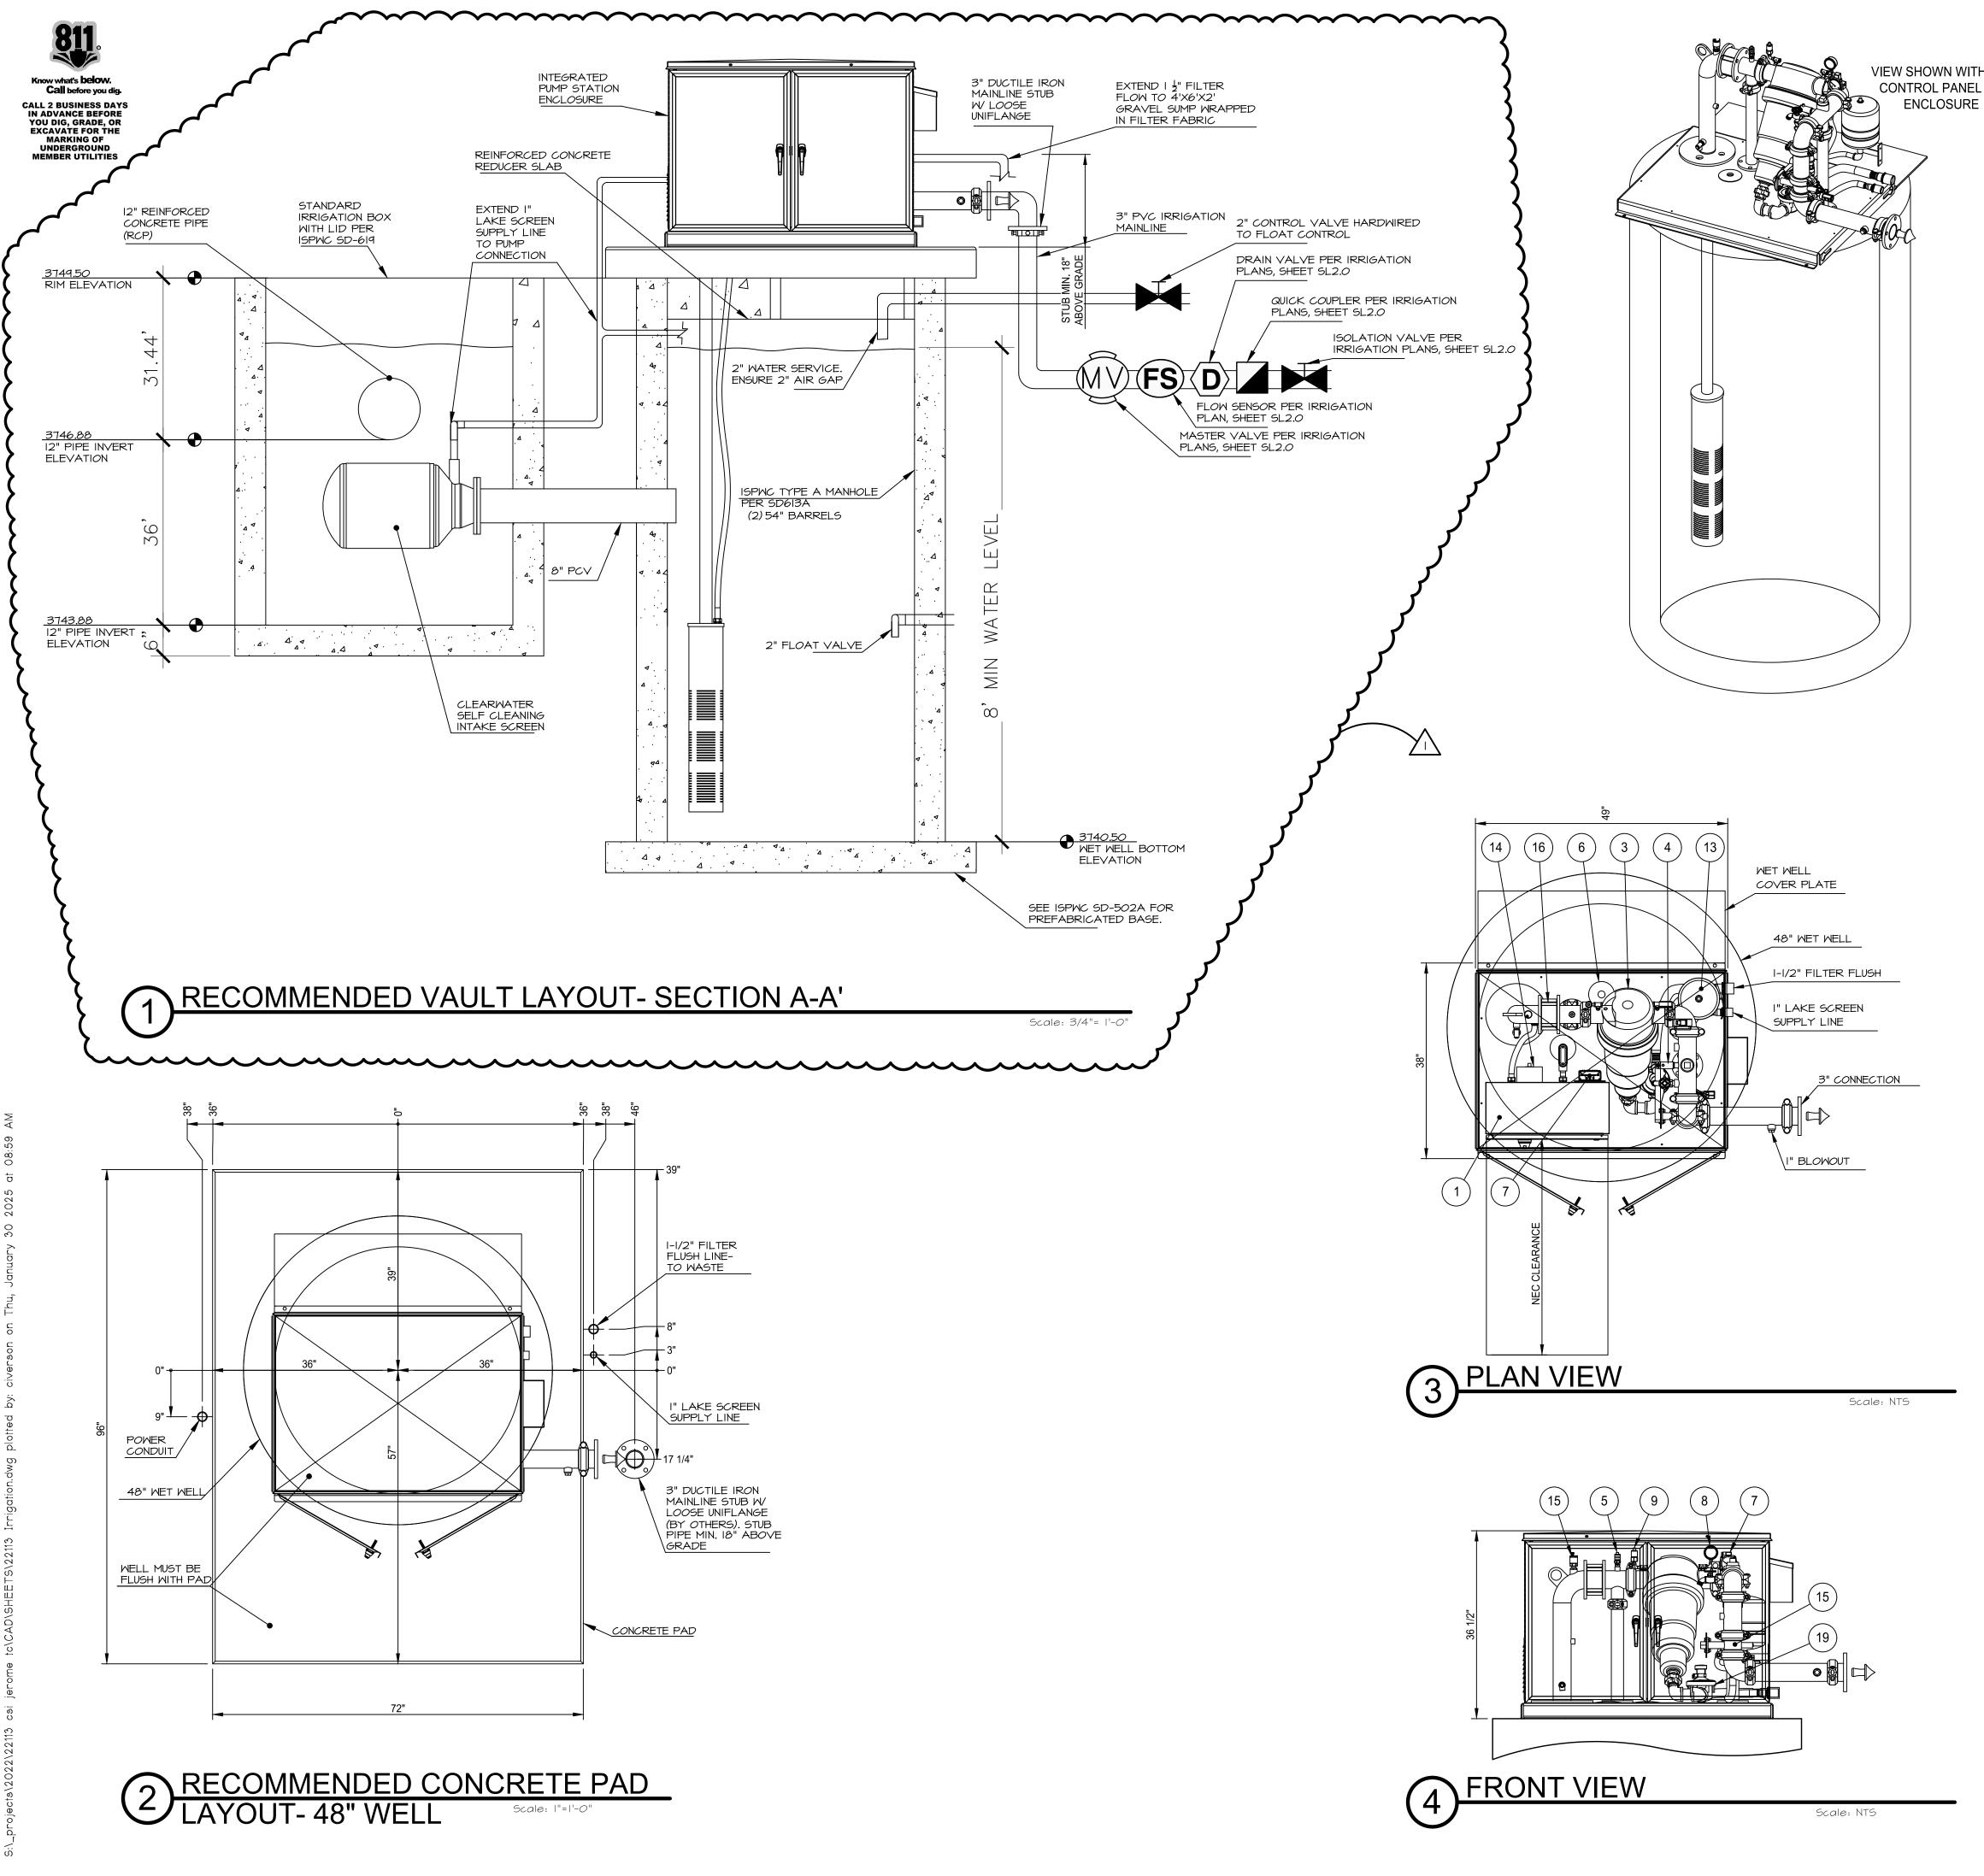


IOUT	
OR	

	DESIGN SPECIFICATIO	NS	
DESIG	5N FLOW RATE: 78 GPM @ 75 F	°SI	
POWE	R: 240 VOLT /I PHA	SE	
MODE	EL #: S##VISOO7X00078-075V32B24I0N	5-3	
ITEM NO.	DESCRIPTION QT		
I	CONTROL PANEL	I	
2	ENCLOSURE, MARINE GRADE ALUMINUM, I 2-DOOR		
З	FILTER, VAF200 I		
4	FLOW METER/FLOW SWITCH		
5	HIGH PRESSURE SWITCH I		
6	LEVEL SENSOR/FLOAT SWITCH CAP 2		
٦	MODEM I		
8	PRESSURE DIFFERENTIAL GAUGE & I SWITCH		
٩	PRESSURE GAUGE		
10	PRESSURE TRANSDUCER I		
П	PUMP, SUBMERSIBLE I		
12	SKID, BENT I		
13	TANK, PRESSURE		
14	UTILITY HEATER I		
15	VALVE, AIR RELIEF, FV-4		
16	VALVE, BUTTERFLY, GROOVE, LEVER I		
דו	VALVE, CHECK, SILENT	I	
18	VALVE, FILTER FLUSH	2	
19	VALVE, LAKE SCREEN SUPPLY	I	
20	VALVE, PRESSURE RELIEF	Ι	

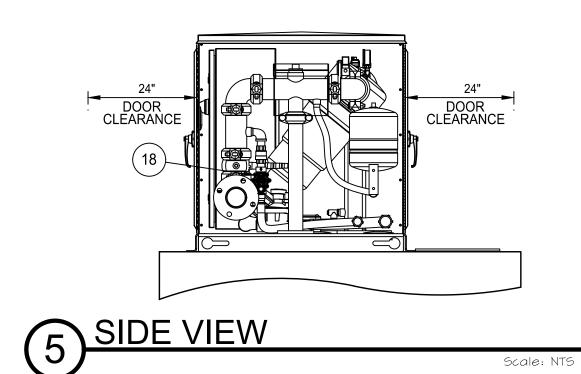


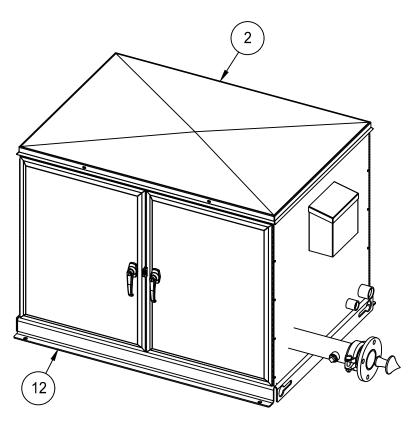



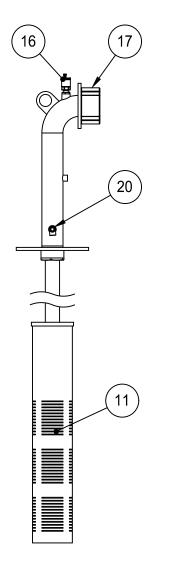



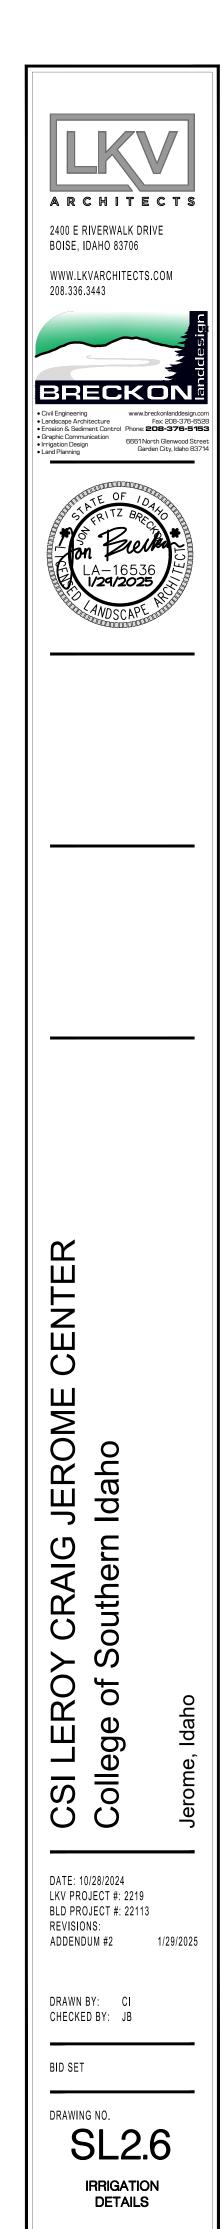

Scale: NTS

Scale: NTS



645 West 25<sup>th</sup> Street Idaho Falls, Idaho 83402 (208) 523.2862

### www.musgrovepa.com

OVER 45 YEARS OF ENGINEERING EXCELLENCE

## **ADDENDUM #2**

## (MECHANICAL)

Date:	01/30/25	To:	LKV Architects
Job Number:	23-319		2400 E. Riverside Drive
Prepared By:	Joe Davies		Boise, ID 83706
Sheet:	1 of 1	Attention:	Greg Bush / Ron Polintan

## Project: <u>CSI – LeRoy Craig Jerome Center</u>

**NOTICE TO BIDDERS:** THIS ADDENDUM IS HEREBY MADE A PART OF THE PROJECT REQUIREMENTS AND CONTRACT DOCUMENTS FOR THE PROJECT REFERENCED ABOVE.

## Mechanical

## Alternate Manufacturers Approvals:

The following manufacturers shall be approved for bidding only. Final approval shall be based on requirements of plans and specifications.

• Dedicated Outside Air System (DOAS) – CaptiveAire

## Specification modifications:

- Section 230900 Direct Digital controls
  - o Section 2.3 Operator workstation requirements was modified.
  - Section 2.3.B through 2.3.T removed
  - Section 2.3.A updated to reflect that workstations are existing and shall be tied into for the new system.
    Shall now read:
    - The operator workstation portion of the BAS shall consist of tying into existing full-powered configuration and programming workstations, and existing web-based operator workstations. For this project the new automation server should be connected to the existing system for full functionality to access BAS remotely.



### www.musgrovepa.com

OVER 45 YEARS OF ENGINEERING EXCELLENCE

## **ADDENDUM #2**

## (ELECTRICAL)

Date:	01/30/25	To:	LKV Architects
Job Number:	23-319		2400 E. Riverside Drive
Prepared By:	Matt Bradley		Boise, ID 83706
Sheet:	1 of 1	Attention:	Greg Bush / Ron Polintan

## Project: <u>CSI – LeRoy Craig Jerome Center</u>

**NOTICE TO BIDDERS:** THIS ADDENDUM IS HEREBY MADE A PART OF THE PROJECT REQUIREMENTS AND CONTRACT DOCUMENTS FOR THE PROJECT REFERENCED ABOVE.

## **Electrical**

## Specification modifications:

- Section 262416
  - o Section 2.1 A Manufacturers: Siemens was removed from the approved list.
- Section 262416
  - o Section 2.1 A Manufacturers: Siemens was removed from the approved list.
- Section 282300
  - Section 2.1 C) Removed "cabling, pathways, raceways, cable trays, related to this system such that the end results is a complete functional system.."
  - Video Retention Period is required to be 30 days.
- Section 281300
  - o Section 2.2 D(b) Revised to "Provide Seneca Reliance 200 series server, current model or equal."
    - A new Video Access control server is required for this project and is required to be integrated into the existing Genetec video server located at the Main CSI campus in Twin Falls.
    - 8 hours of end user training is required for this project as part of 2813300
  - Section 2.4 I Removed from specification: Door hardware is not provided by Section 281300.
    - 19 Schlage AD-300 and AD-400 electronic locks
    - 20 Schlage Control wireless lock
    - 21 Schlage LE Networked wireless Mortise lock
    - 22 Schlage NDE Networked wireless lock
    - 23 Section 281300